



7/11/18 PLR NOTES

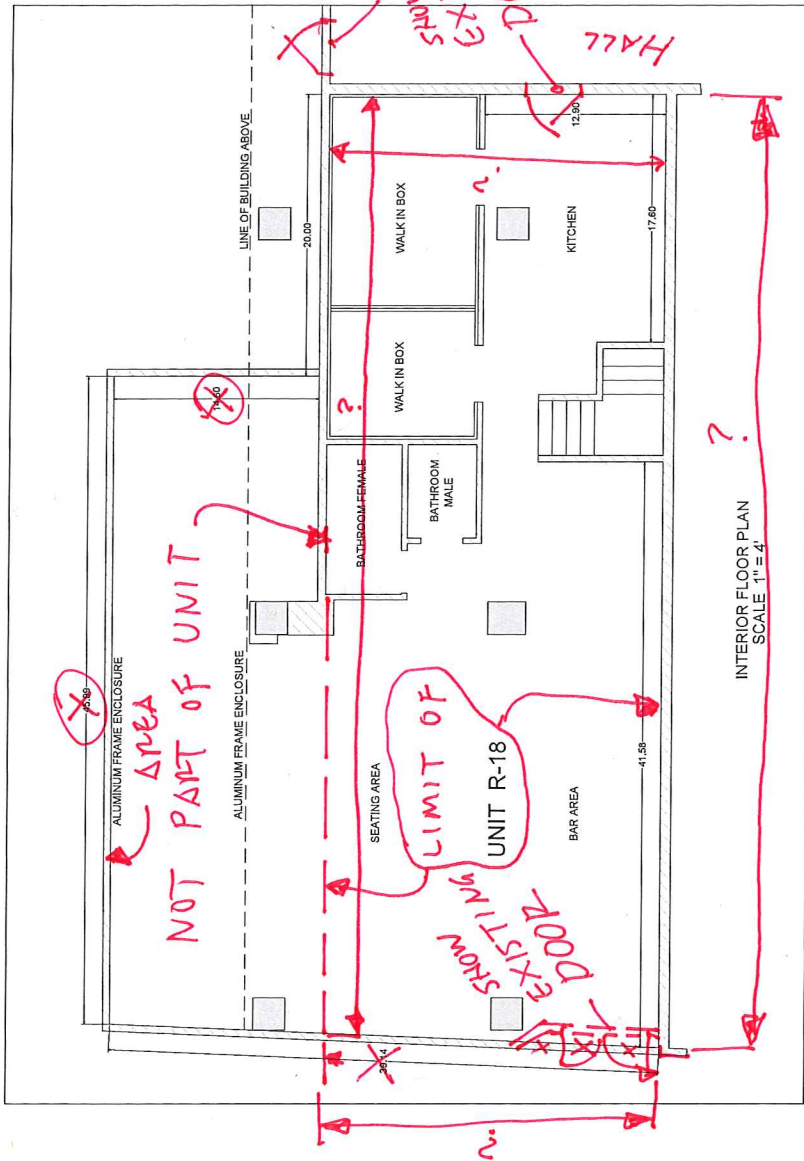

SHOW EXISTING DOOR
 EXISTING DOOR
 EXISTING DOOR

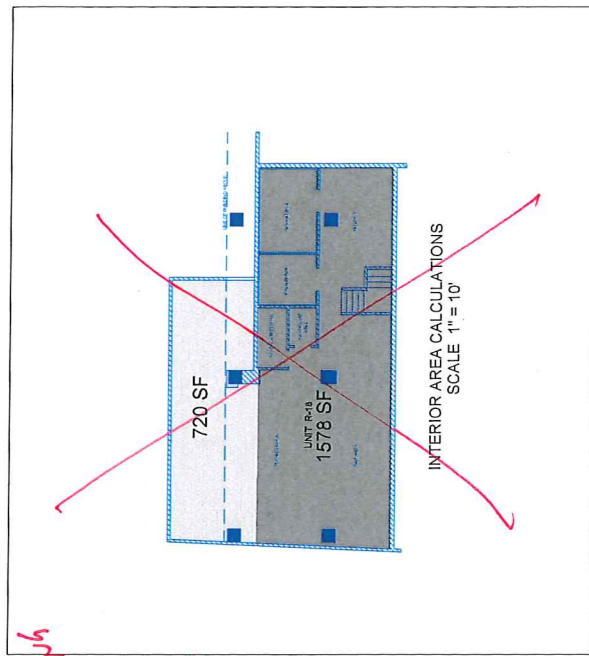

SURVEY REFERENCE
 1. MASTER DEED "OCEAN CLUB CONDOMINIUM" DB 3884 P 47
 2. 2018 AP TO COMMERCIAL UNIT AREAS & PERCENTAGES

NO.	DATE	BY	DESCRIPTION

CONTRACTOR'S RESPONSIBILITY: THE CONTRACTOR SHALL BE RESPONSIBLE FOR OBTAINING ALL NECESSARY PERMITS AND APPROVALS FROM THE LOCAL GOVERNMENT AGENCIES AND THE STATE OF NEW JERSEY. THE CONTRACTOR SHALL BE RESPONSIBLE FOR OBTAINING ALL NECESSARY PERMITS AND APPROVALS FROM THE LOCAL GOVERNMENT AGENCIES AND THE STATE OF NEW JERSEY. THE CONTRACTOR SHALL BE RESPONSIBLE FOR OBTAINING ALL NECESSARY PERMITS AND APPROVALS FROM THE LOCAL GOVERNMENT AGENCIES AND THE STATE OF NEW JERSEY.

AWP
 ARTHUR W. PONZIO CO. & ASSOCIATES, INC.
 400 NORTH ZOOVER AVENUE, ATLANTIC CITY, N.J. 08401
 PHONE: 856-848-8888 FAX: 856-848-8888
 WWW.AWPINC.COM

DANIEL J. PONZIO SR.
 PROFESSIONAL LAND SURVEYOR N.J. No. 6537803

SHEET NO. **C-1**
 SURVEY OF UNIT R-18 "THE OCEAN CLUB"
 CELEBRITY CORNER 3101 BOARDWALK
 ATLANTIC CITY ATLANTIC COUNTY NEW JERSEY
 BY: D.J.P. SR.
 DATE: 4/30/18
 PROJ. NO.: 33190

TO: **DOMINIC GAGGIANO**