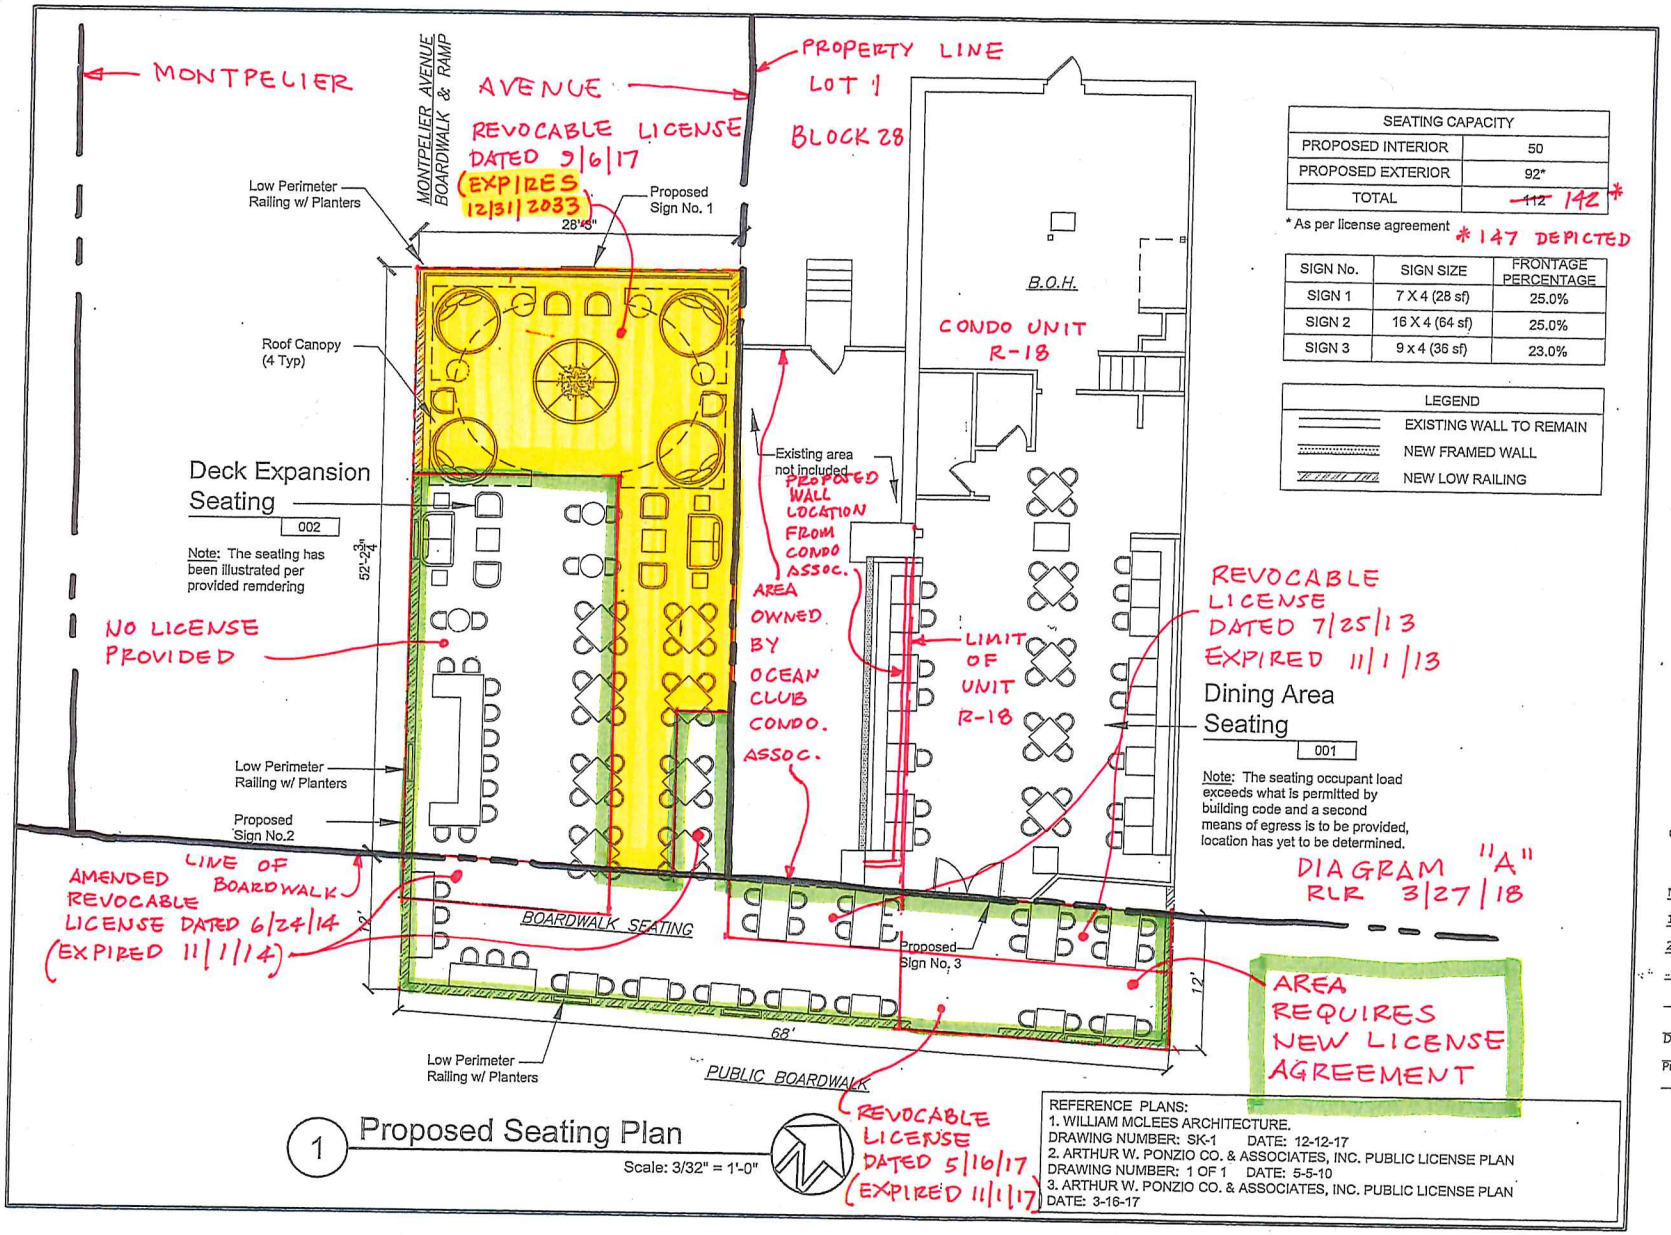

1 Proposed Seating Plan

Scale: 3/32" = 1'-0"

SEATING CAPACITY	
PROPOSED INTERIOR	50
PROPOSED EXTERIOR	92*
TOTAL	~~112~~ 142 *

* As per license agreement * 147 DEPICTED

SIGN No.	SIGN SIZE	FRONTAGE PERCENTAGE
SIGN 1	7 X 4 (28 sf)	25.0%
SIGN 2	16 X 4 (64 sf)	25.0%
SIGN 3	9 x 4 (36 sf)	23.0%

LEGEND	
	EXISTING WALL TO REMAIN
	NEW FRAMED WALL
	NEW LOW RAILING

REFERENCE PLANS:
1. WILLIAM MCLEES ARCHITECTURE.
DRAWING NUMBER: SK-1 DATE: 12-12-17
2. ARTHUR W. PONZIO CO. & ASSOCIATES, INC. PUBLIC LICENSE PLAN
DRAWING NUMBER: 1 OF 1 DATE: 5-5-10
3. ARTHUR W. PONZIO CO. & ASSOCIATES, INC. PUBLIC LICENSE PLAN
DATE: 3-16-17

ai5 studios
Architecture + Interior Design
701 west avenue, suite 301
ocean city, nj 08226
tel. 609.398.4477
www.hdg-nj.com
cert. of auth. no. 21AC00040300

NOT FOR CONSTRUCTION

Project:
Celebrity Corner

Location:
3101 Boardwalk
Atlantic City
Atlantic County
New Jersey

Client:
Celebrity Corner, Inc.

No.	Description	Date
1.	Initial Issuance	03.22.18
2.	General Revision	03.23.18

Drawn By: SAO/TLS Checked By: Guse
Project No. 31411.02

PROPOSED SEATING LAYOUT

SK101

Sheet 1 of 1